

LEGAL DESCRIPTION:


Lot 7, Block 1, WAYZATA, Hennepin County, Minnesota.

SCOPE OF WORK & LIMITATIONS:

1. Showing the length and direction of boundary lines of the legal description listed above. The scope of our services does not include determining what you own, which is a legal matter. Please check the legal description with your records or consult with competent legal counsel, if necessary, to make sure that it is correct and that any matters of record, such as easements, that you wish to be included on the survey have been shown.
2. Showing the location of observed existing improvements we deem necessary for the survey.
3. Setting survey markers or verifying existing survey markers to establish the corners of the property.
4. This survey has been completed without the benefit of a current title commitment. There may be existing easements or other encumbrances that would be revealed by a current title commitment. Therefore, this survey does not purport to show any easements or encumbrances other than the ones shown hereon.
5. Note that all building dimensions and building tie dimensions to the property lines, are taken from the siding and or stucco of the building.
6. Showing and tabulating impervious surface coverage of the lot for your review and for the review of such governmental agencies that may have jurisdiction over these requirements to verify they are correctly shown before proceeding with construction.
7. Showing elevations on the site at selected locations to give some indication of the topography of the site. We have also provided a benchmark for your use in determining elevations for construction on this site. The elevations shown relate only to the benchmark provided on this survey. Use that benchmark and check at least one other feature shown on the survey when determining other elevations for use on this site or before beginning construction.

STANDARD SYMBOLS & CONVENTIONS:

"●" Denotes iron survey marker, set, unless otherwise noted.

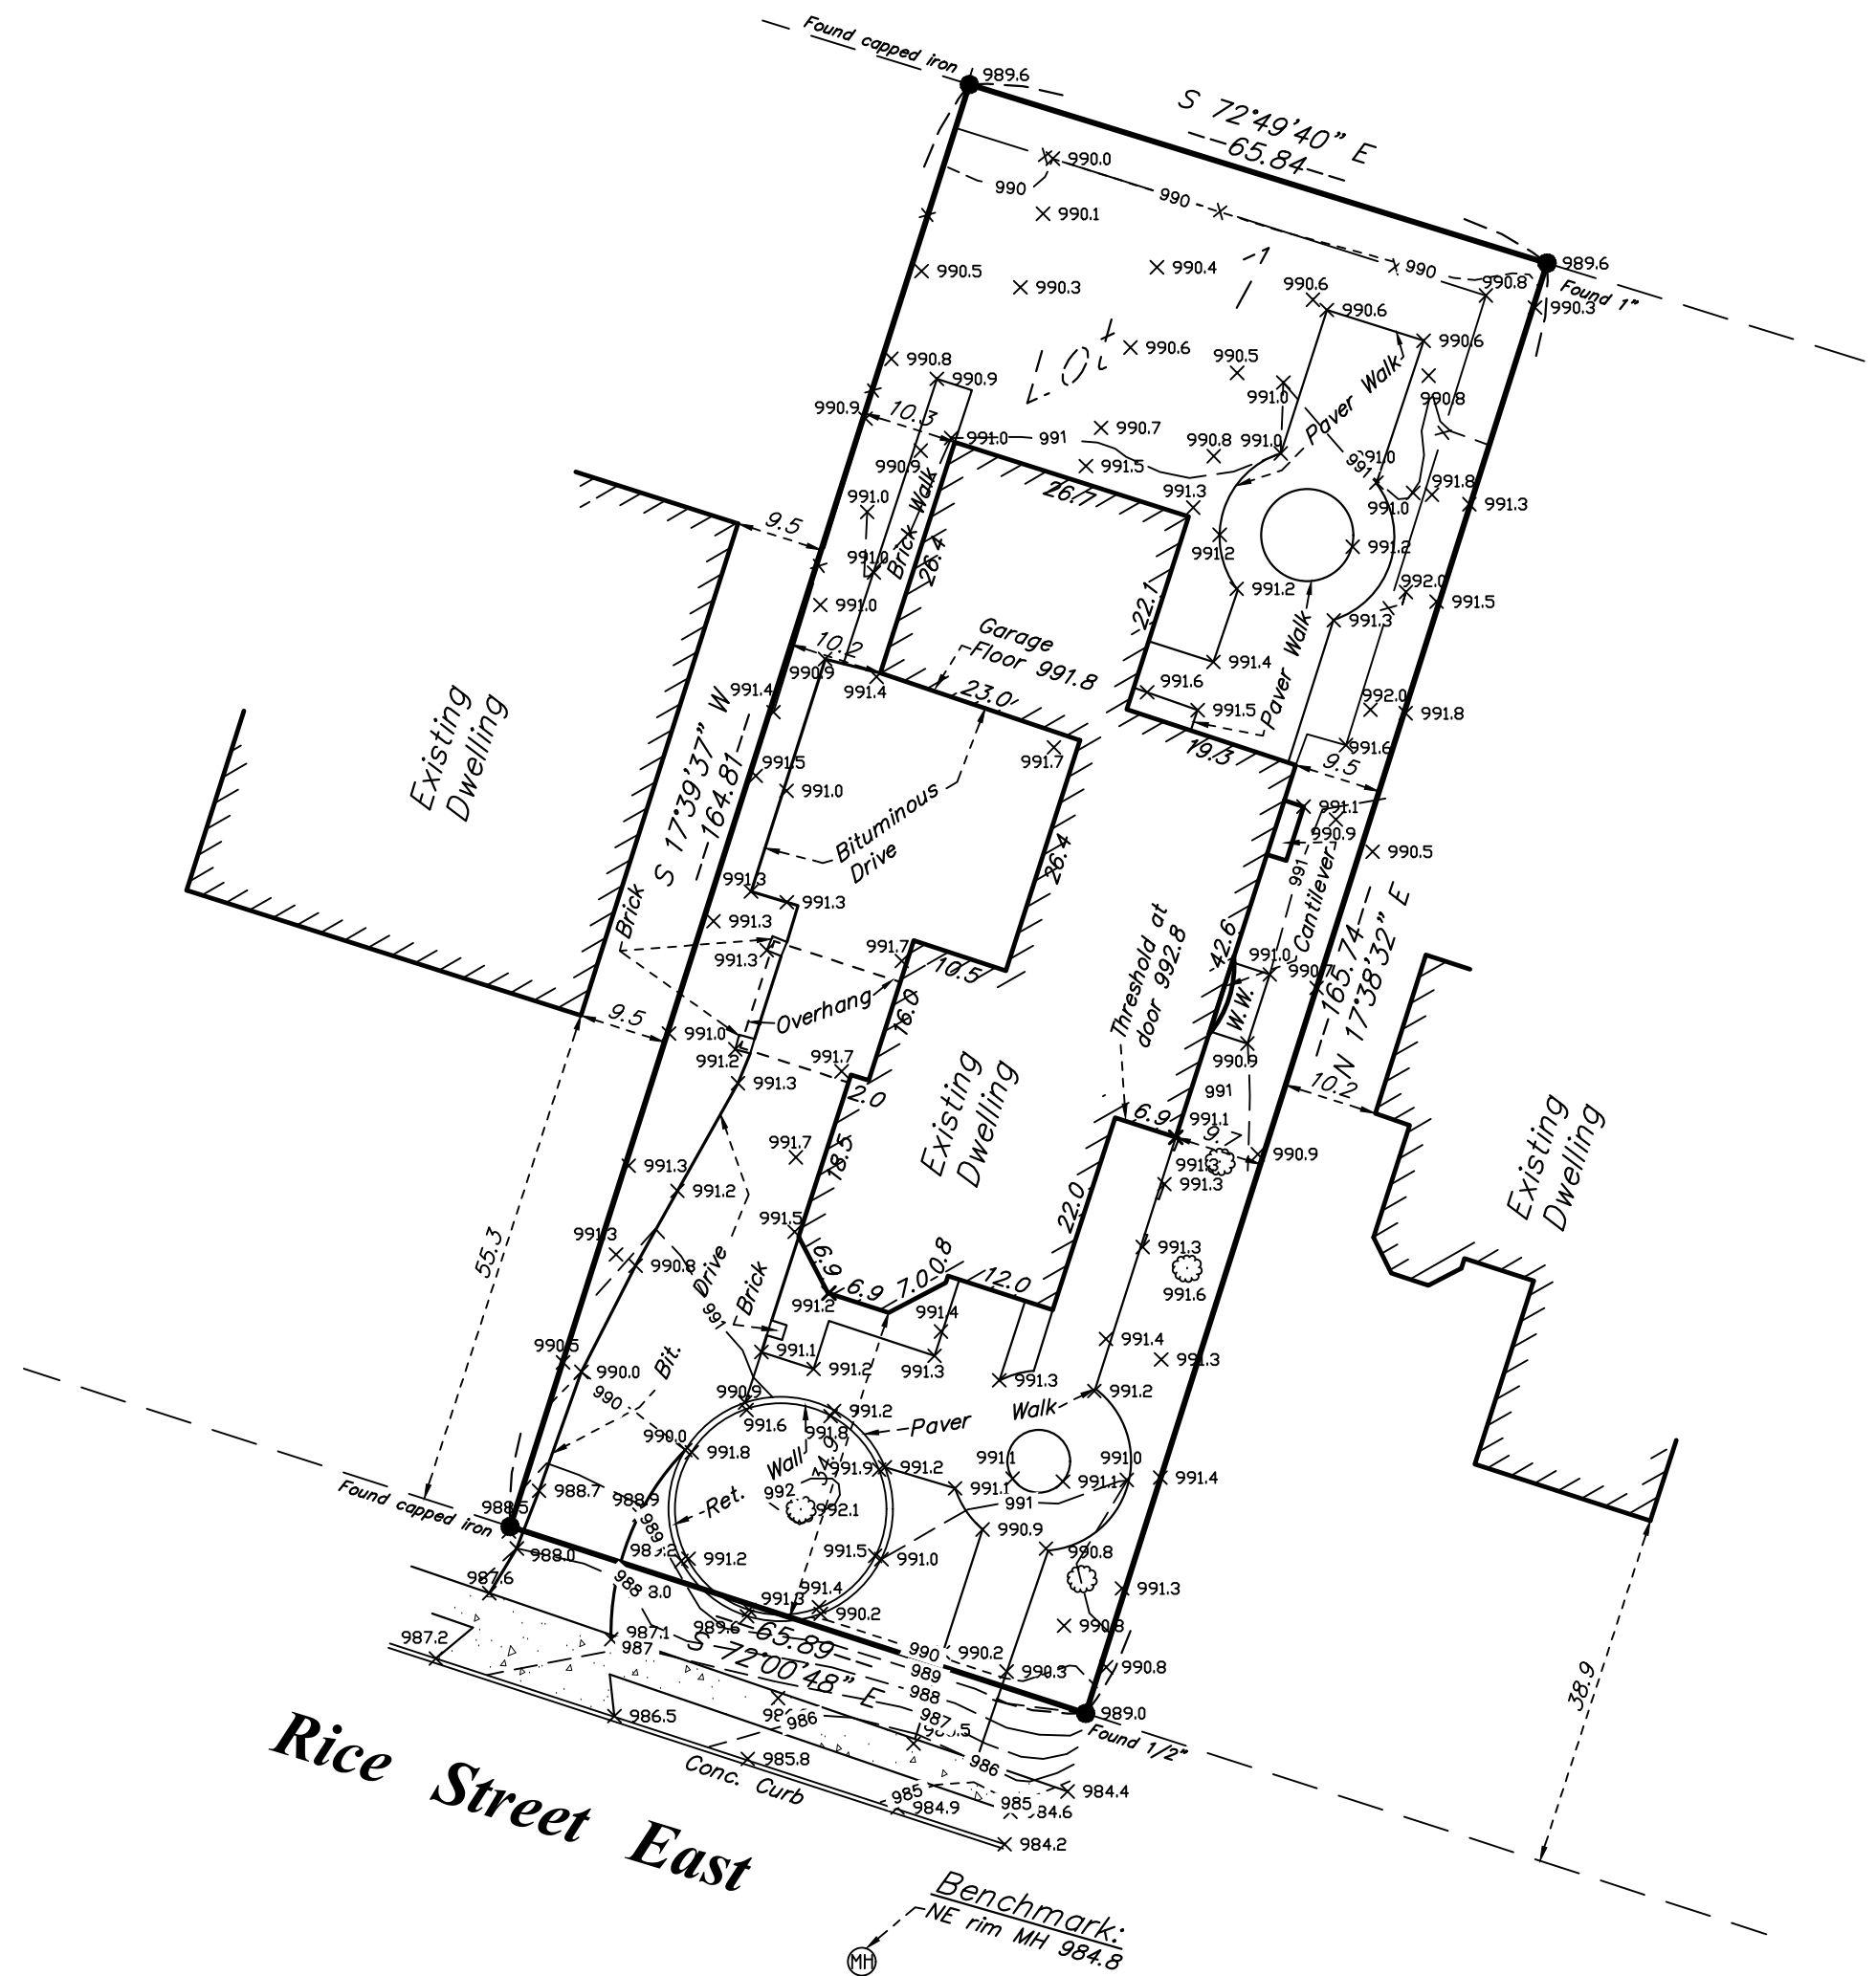


LEGEND

	= CATCH BASIN
	= GAS METER
	= FIRE HYDRANT
	= POWER POLE
	= MANHOLE
	= TELEPHONE PED.
	= ELEC. TRANSFORMER
	= WELL
	= GATE VALVE
	= LIGHT POLE
	= TREE
	= FENCE LINE
	= SANITARY SEWER LINE
	= WATER LINE
	= GAS LINE
	= STORM DRAIN LINE
	= OVERHEAD UTILITY LINE
	= CONCRETE SURFACE

EXISTING HARDCOVER	
House	2,502 Sq. Ft.
Bituminous Driveway	1,783 Sq. Ft.
Brick Areas	144 Sq. Ft.
Paver Walks	1,444 Sq. Ft.
Ret. Walls	45 Sq. Ft.
TOTAL EXISTING HARDCOVER	5,918 Sq. Ft.
AREA OF LOT	10,885 Sq. Ft.
PERCENTAGE OF HARDCOVER TO LOT	54.4%

DATE	REVISION DESCRIPTION

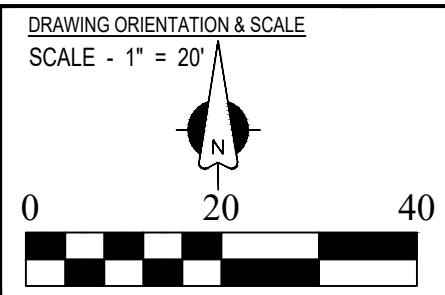

CLIENT NAME / JOB ADDRESS

JEFF VONGILLERN

715 RICE STREET EAST
WAYZATA, MN

Advance
Surveying & Engineering, Co.

18202 Minnetonka Boulevard, Suite 401
Deephaven, Minnesota 55391
Phone (952) 474-7964
Web: www.advsur.com

I HEREBY CERTIFY THAT THIS PLAN, SURVEY OR REPORT WAS PREPARED BY ME OR UNDER MY DIRECT SUPERVISION AND THAT I AM A DULY REGISTERED LAND SURVEYOR UNDER THE LAWS OF THE STATE OF MINNESOTA.

Thomas M. Bloom
42379
LICENSE NO.
NOVEMBER 3, 2023
DATE

DATE SURVEYED: NOVEMBER 2, 2023

DATE DRAFTED: NOVEMBER 3, 2023

SHEET TITLE
EXISTING CONDITIONS SURVEY

DRAWING NUMBER
231519 TB

SHEET SIZE 17 X 22

SHEET NO.
S1

SHEET 1 OF 1